

Client Name
Hyperion Investments Ltd.


Structural Engineer Name
ARUP

Services Engineer Name
D&M

Consultant Name

Key plan

Notes:
 Do not scale. Figured dimensions only to be taken from this drawing. Check dimensions on site & report discrepancies to the architect.
 This Drawing is protected by copyright. ©
 All areas have been measured from current drawings. They may vary because of (EG) survey, design development, construction tolerances, statutory requirements or re-definition of the areas to be measured.

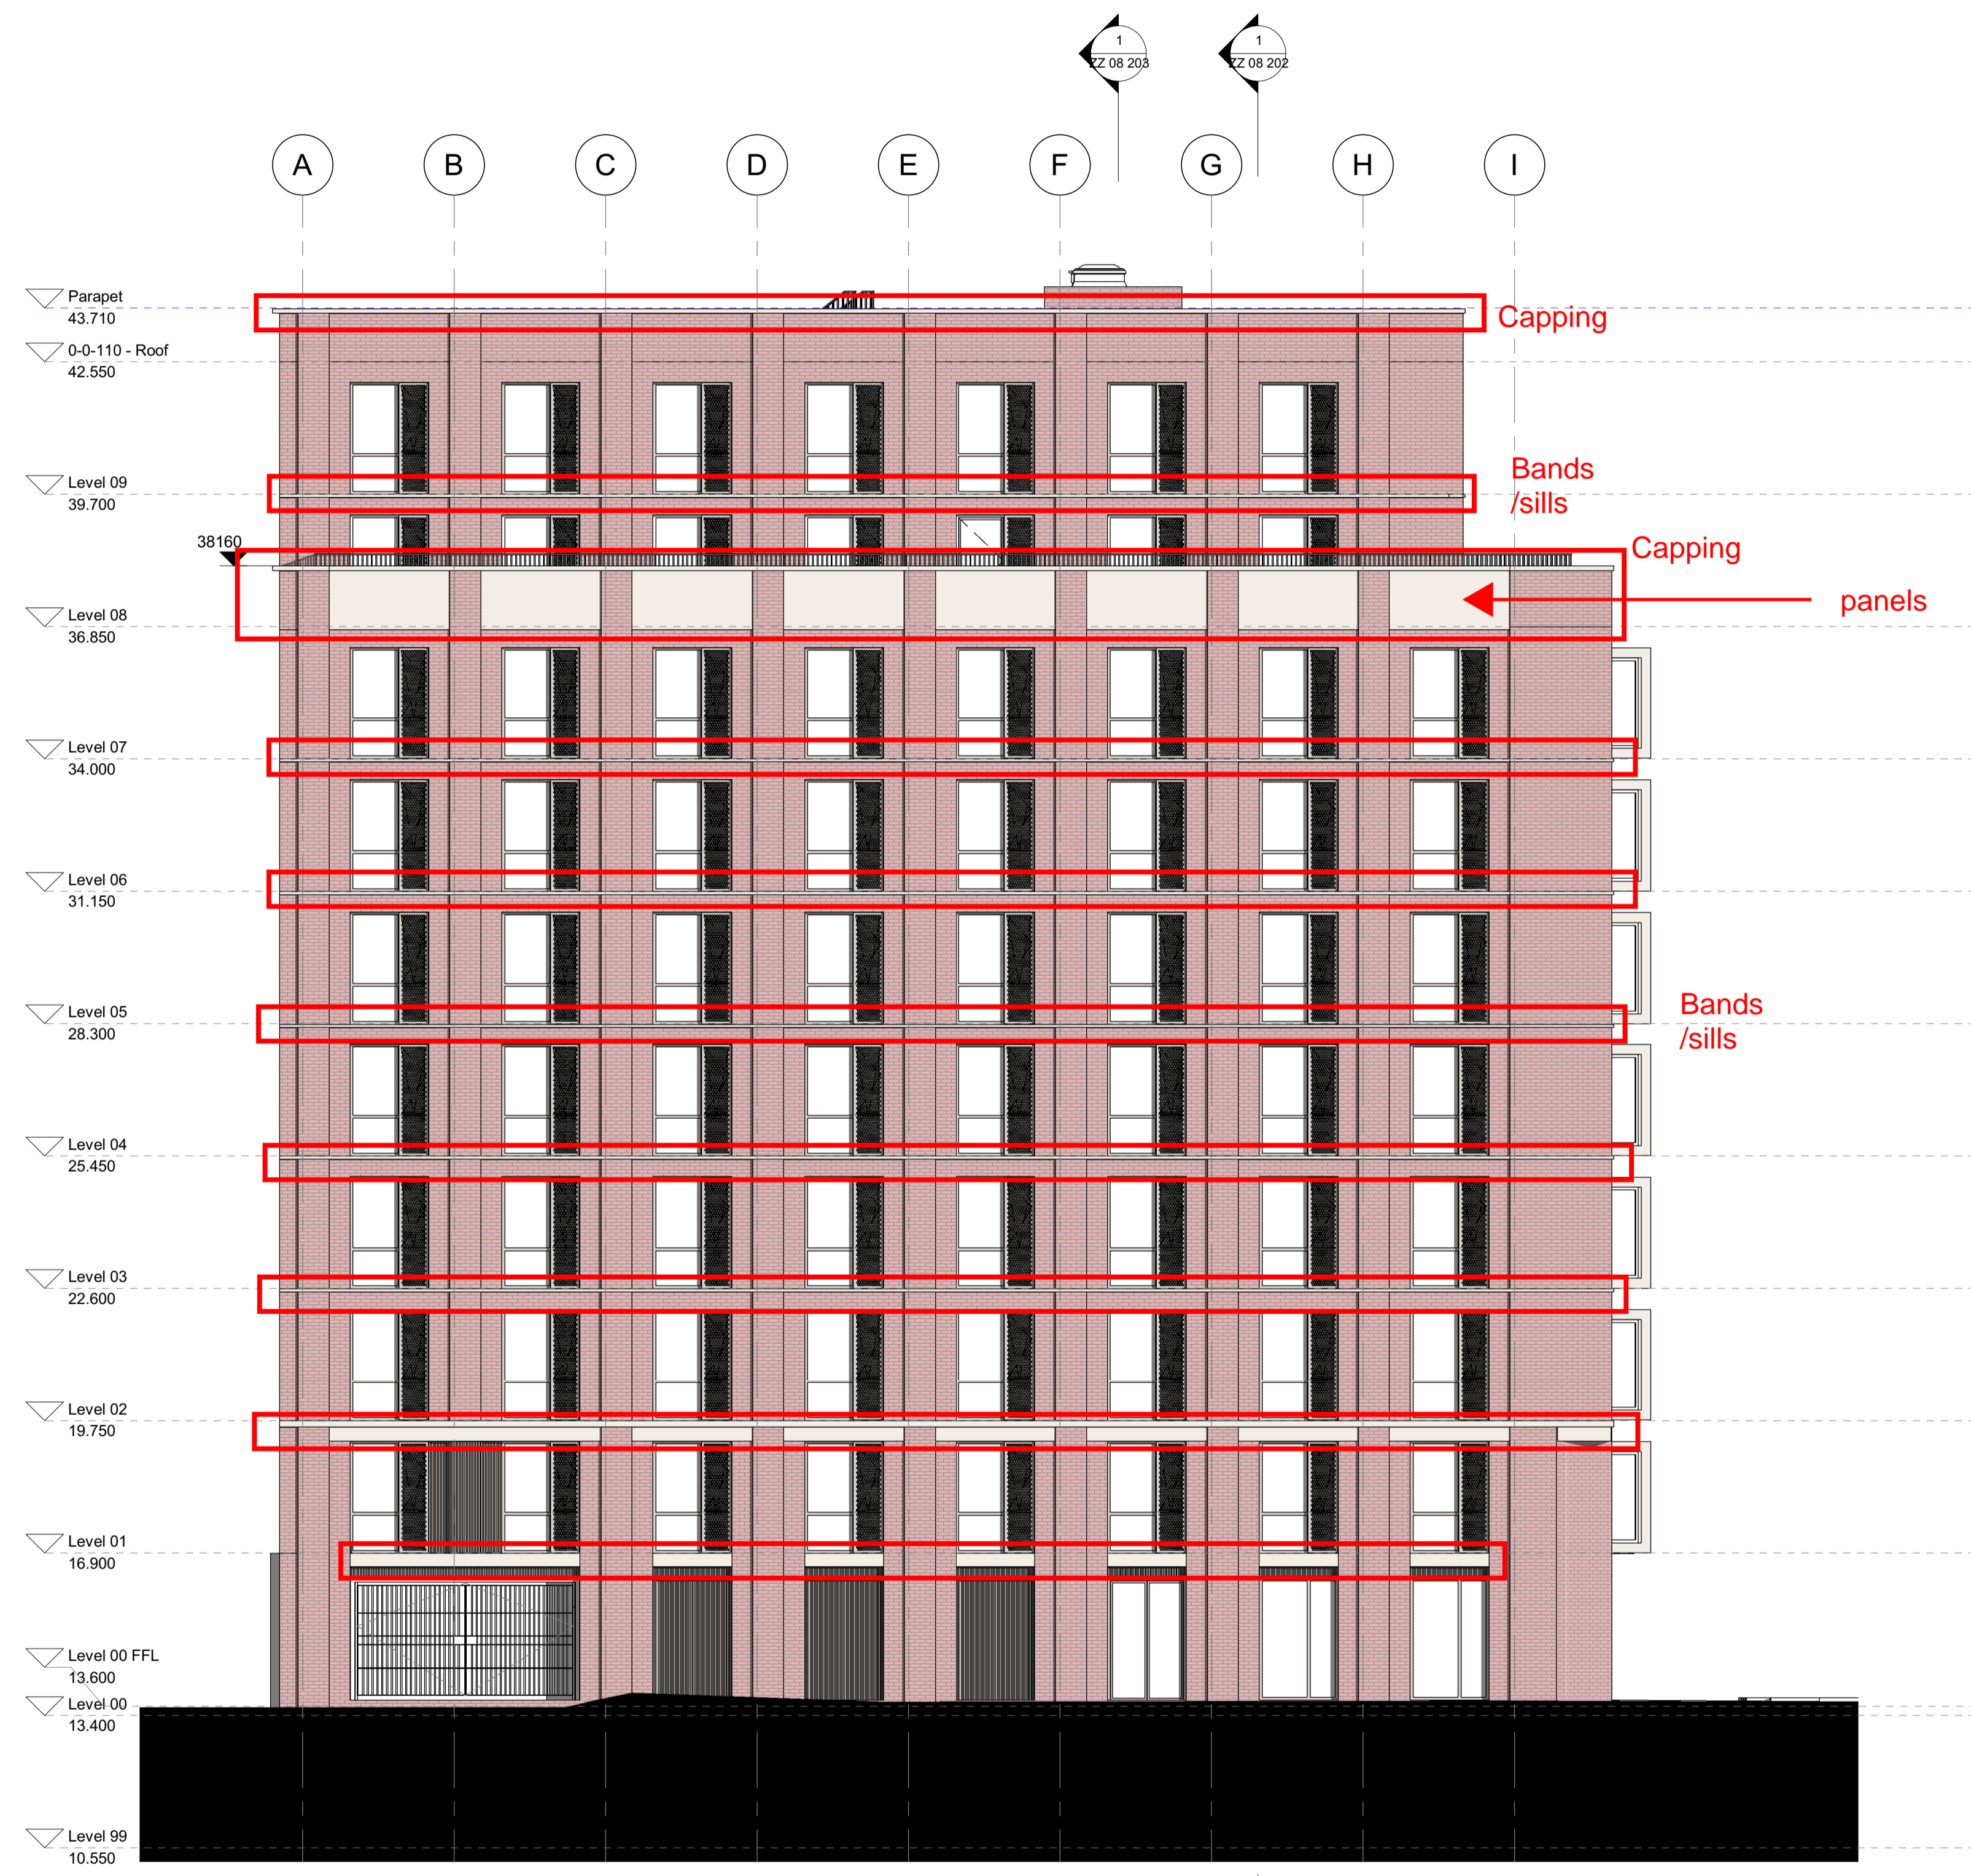

TP Bennett
22/05/2023

WORK IN PROGRESS
INFORMATION ONLY

22/03/2023 17:33:43

No.	Suit	Date	Comment	Drawn	Checked
Revs					

Issue Purpose
Preliminary

tp bennett
 One America Street | London SE1 ONE UK +44 (0) 20 7208 2000
 www.tpennett.com

Project
Fieldgate Street
Whitechapel
London, E1 1JU

Drawing Title
General Arrangement South Elevation

Drawn	Date	Scale @ A1
Author	03/20/23	1:100

Project	Originator	Volume	Level	Type	Role	Number	Subsity	Revision
A11741	TPB	ZZ	ZZ	DR	A	08302	S2	P01