

Client Name  
**Hyperion Investments Ltd.**


Structural Engineer Name  
**ARUP**

Services Engineer Name  
**D&M**

Consultant Name

Key plan

Notes:  
 Do not scale. Figured dimensions only to be taken from this drawing. Check dimensions on site & report discrepancies to the architect.  
 This Drawing is protected by copyright. ©  
 All areas have been measured from current drawings. They may vary because of (EG) survey, design development, construction tolerances, statutory requirements or re-definition of the areas to be measured.

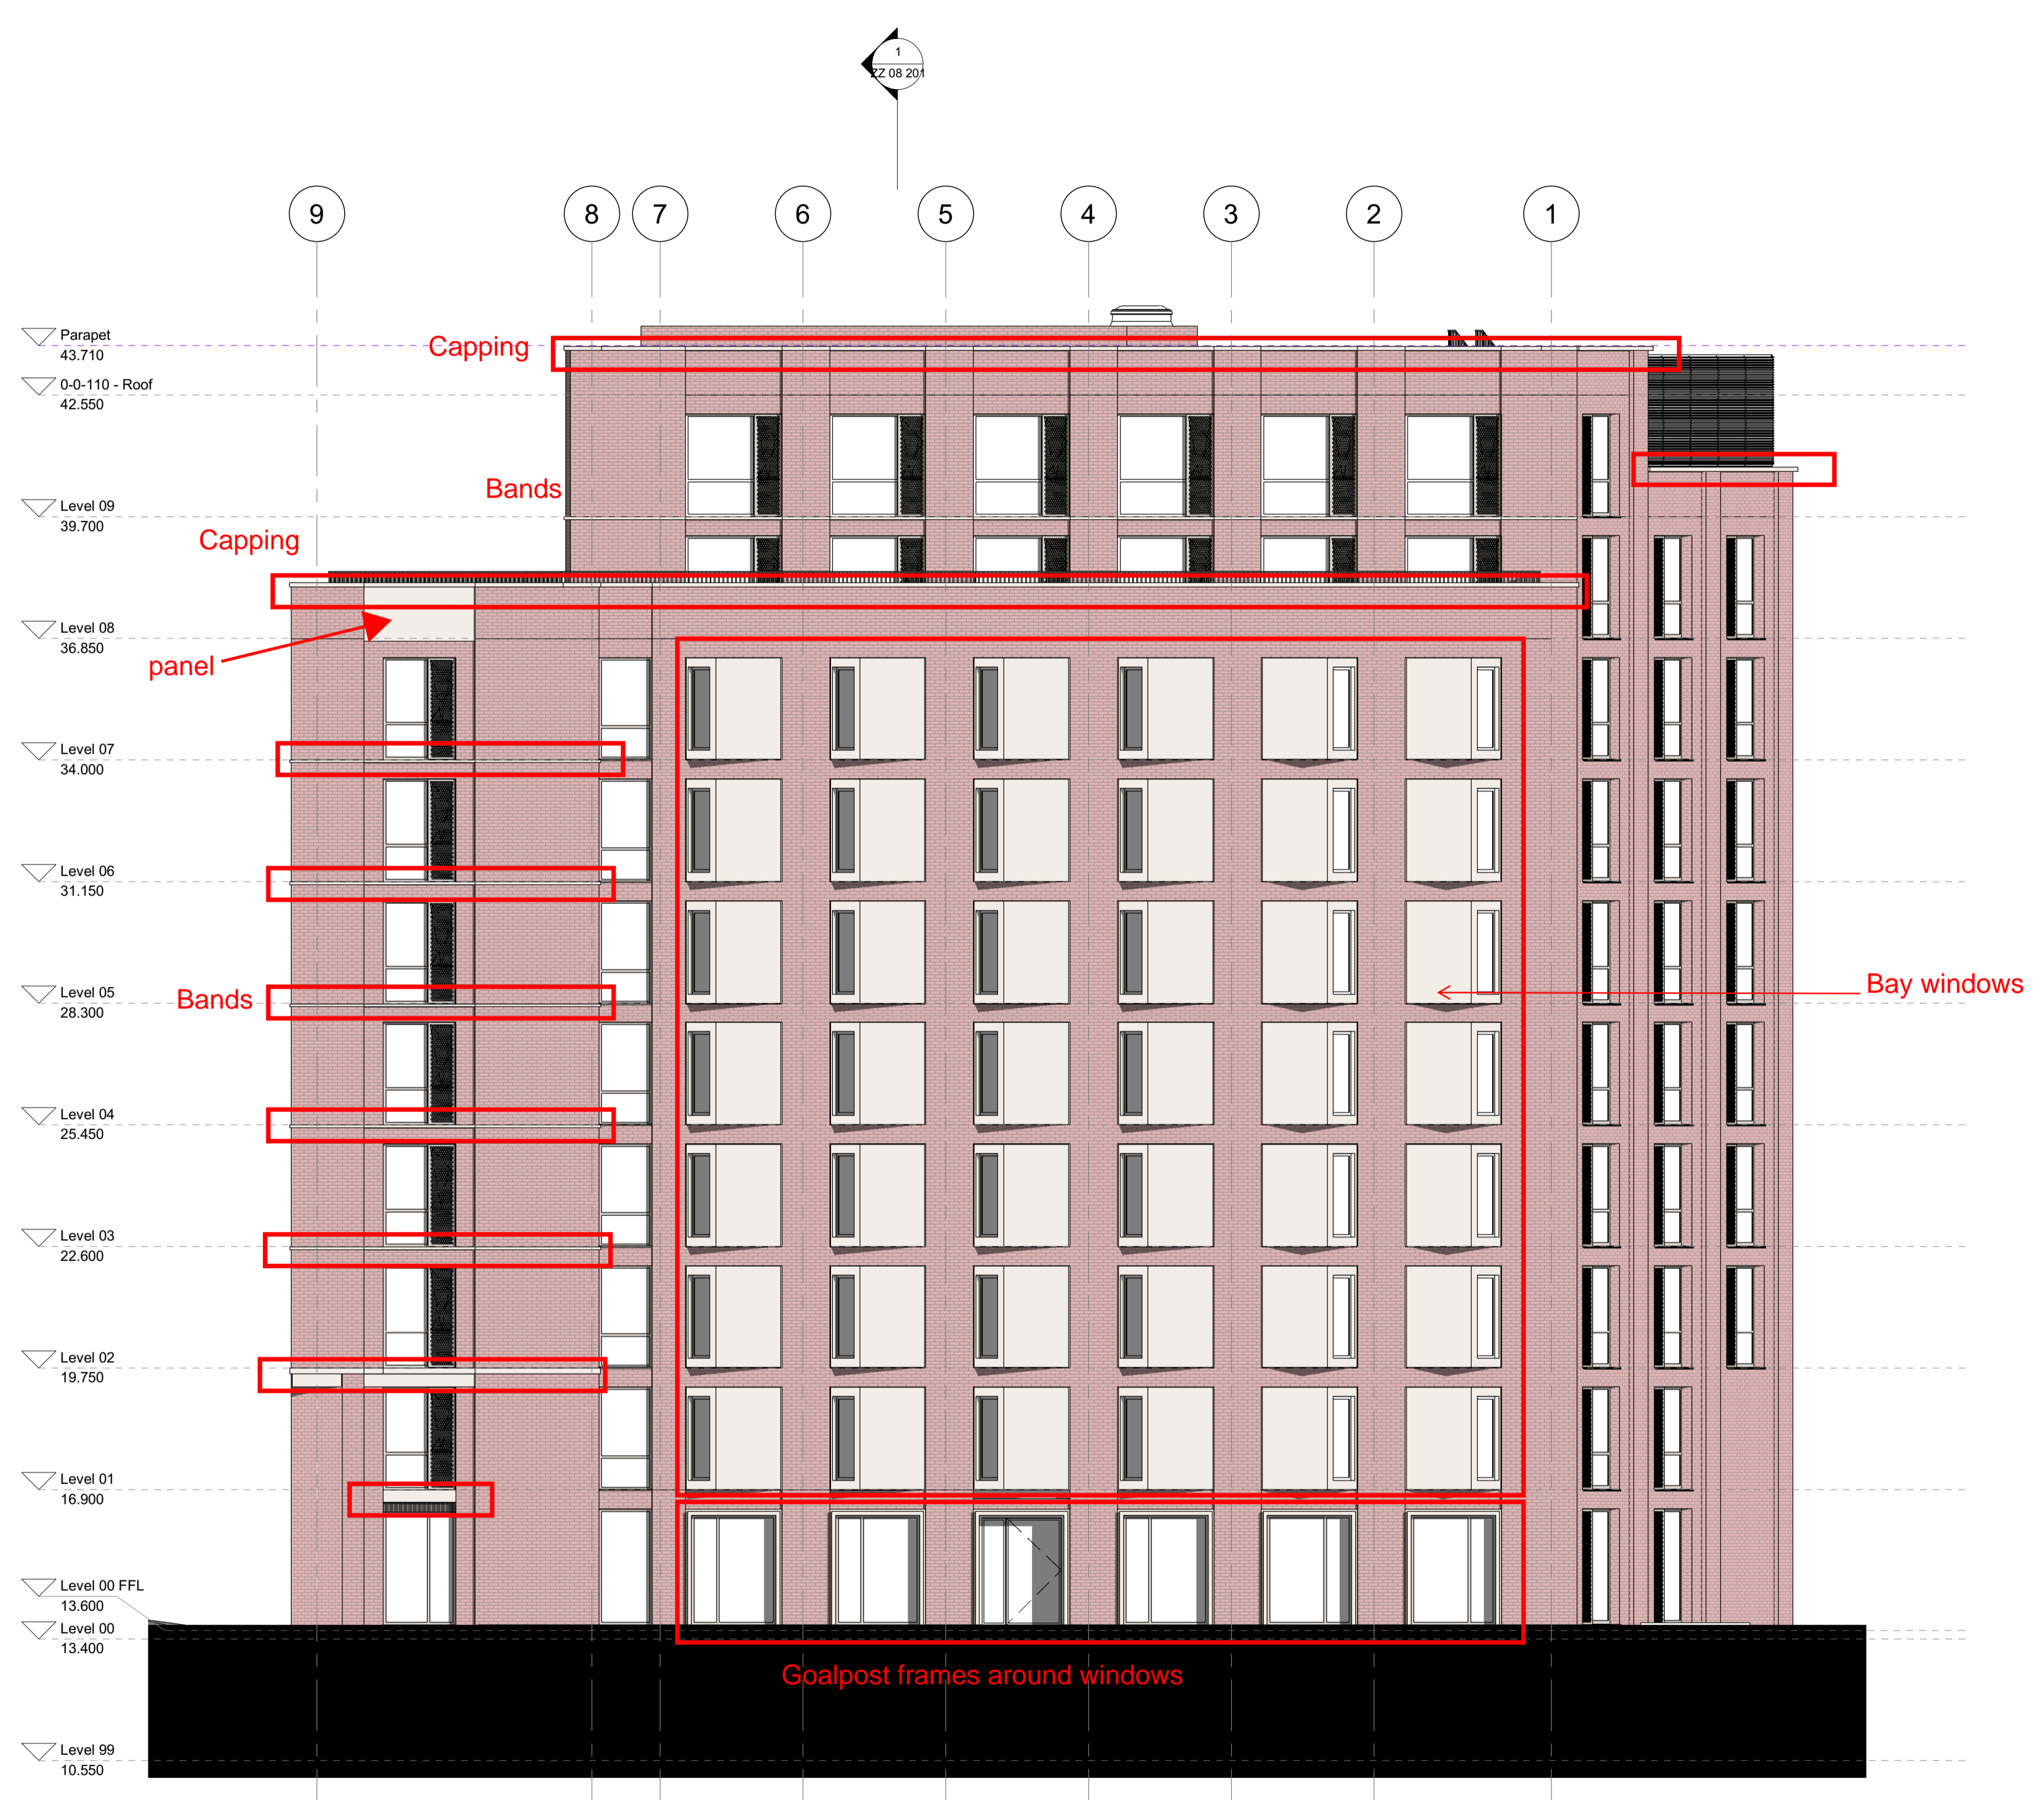

**WORK IN PROGRESS  
 INFORMATION ONLY**

22/03/2023 17:36:00

**TP Bennett  
 22/05/2023**

| No. | Suit | Date | Comment | Drawn | Checked |
|-----|------|------|---------|-------|---------|
| Rev |      |      |         |       |         |

Issue Purpose  
**Preliminary**

**tp bennett**  
 One America Street | London SE1 ONE UK +44 (0) 20 7208 2000  
 www.tpennett.com

Project  
**Fieldgate Street  
 Whitechapel  
 London, E1 1JU**

Drawing Title  
**General Arrangement East Elevation**

| Drawn  | Date     | Scale @ A1 |
|--------|----------|------------|
| Author | 03/20/23 | 1: 100     |

| Project | Originator | Volume | Level | Type | Role | Number | Subality | Revision |
|---------|------------|--------|-------|------|------|--------|----------|----------|
| A11741  | TPB        | ZZ     | ZZ    | DR   | A    | 08303  | S2       | P01      |